



901 NORTH THIRD STREET, SUITE 145  
MINNEAPOLIS, MN 55401  
612.455.3100

CONSULTANT

**PRELIMINARY**  
**NOT FOR CONSTRUCTION**


REVISIONS  
# Date Description

DATE 3.24.14  
PROJECT # 14-0017  
PHASE AS BUILTS


DRAWN BY NR  
CHECKED BY NR

**SUBLEVEL & LEVEL 1 PLANS**

**EX101**

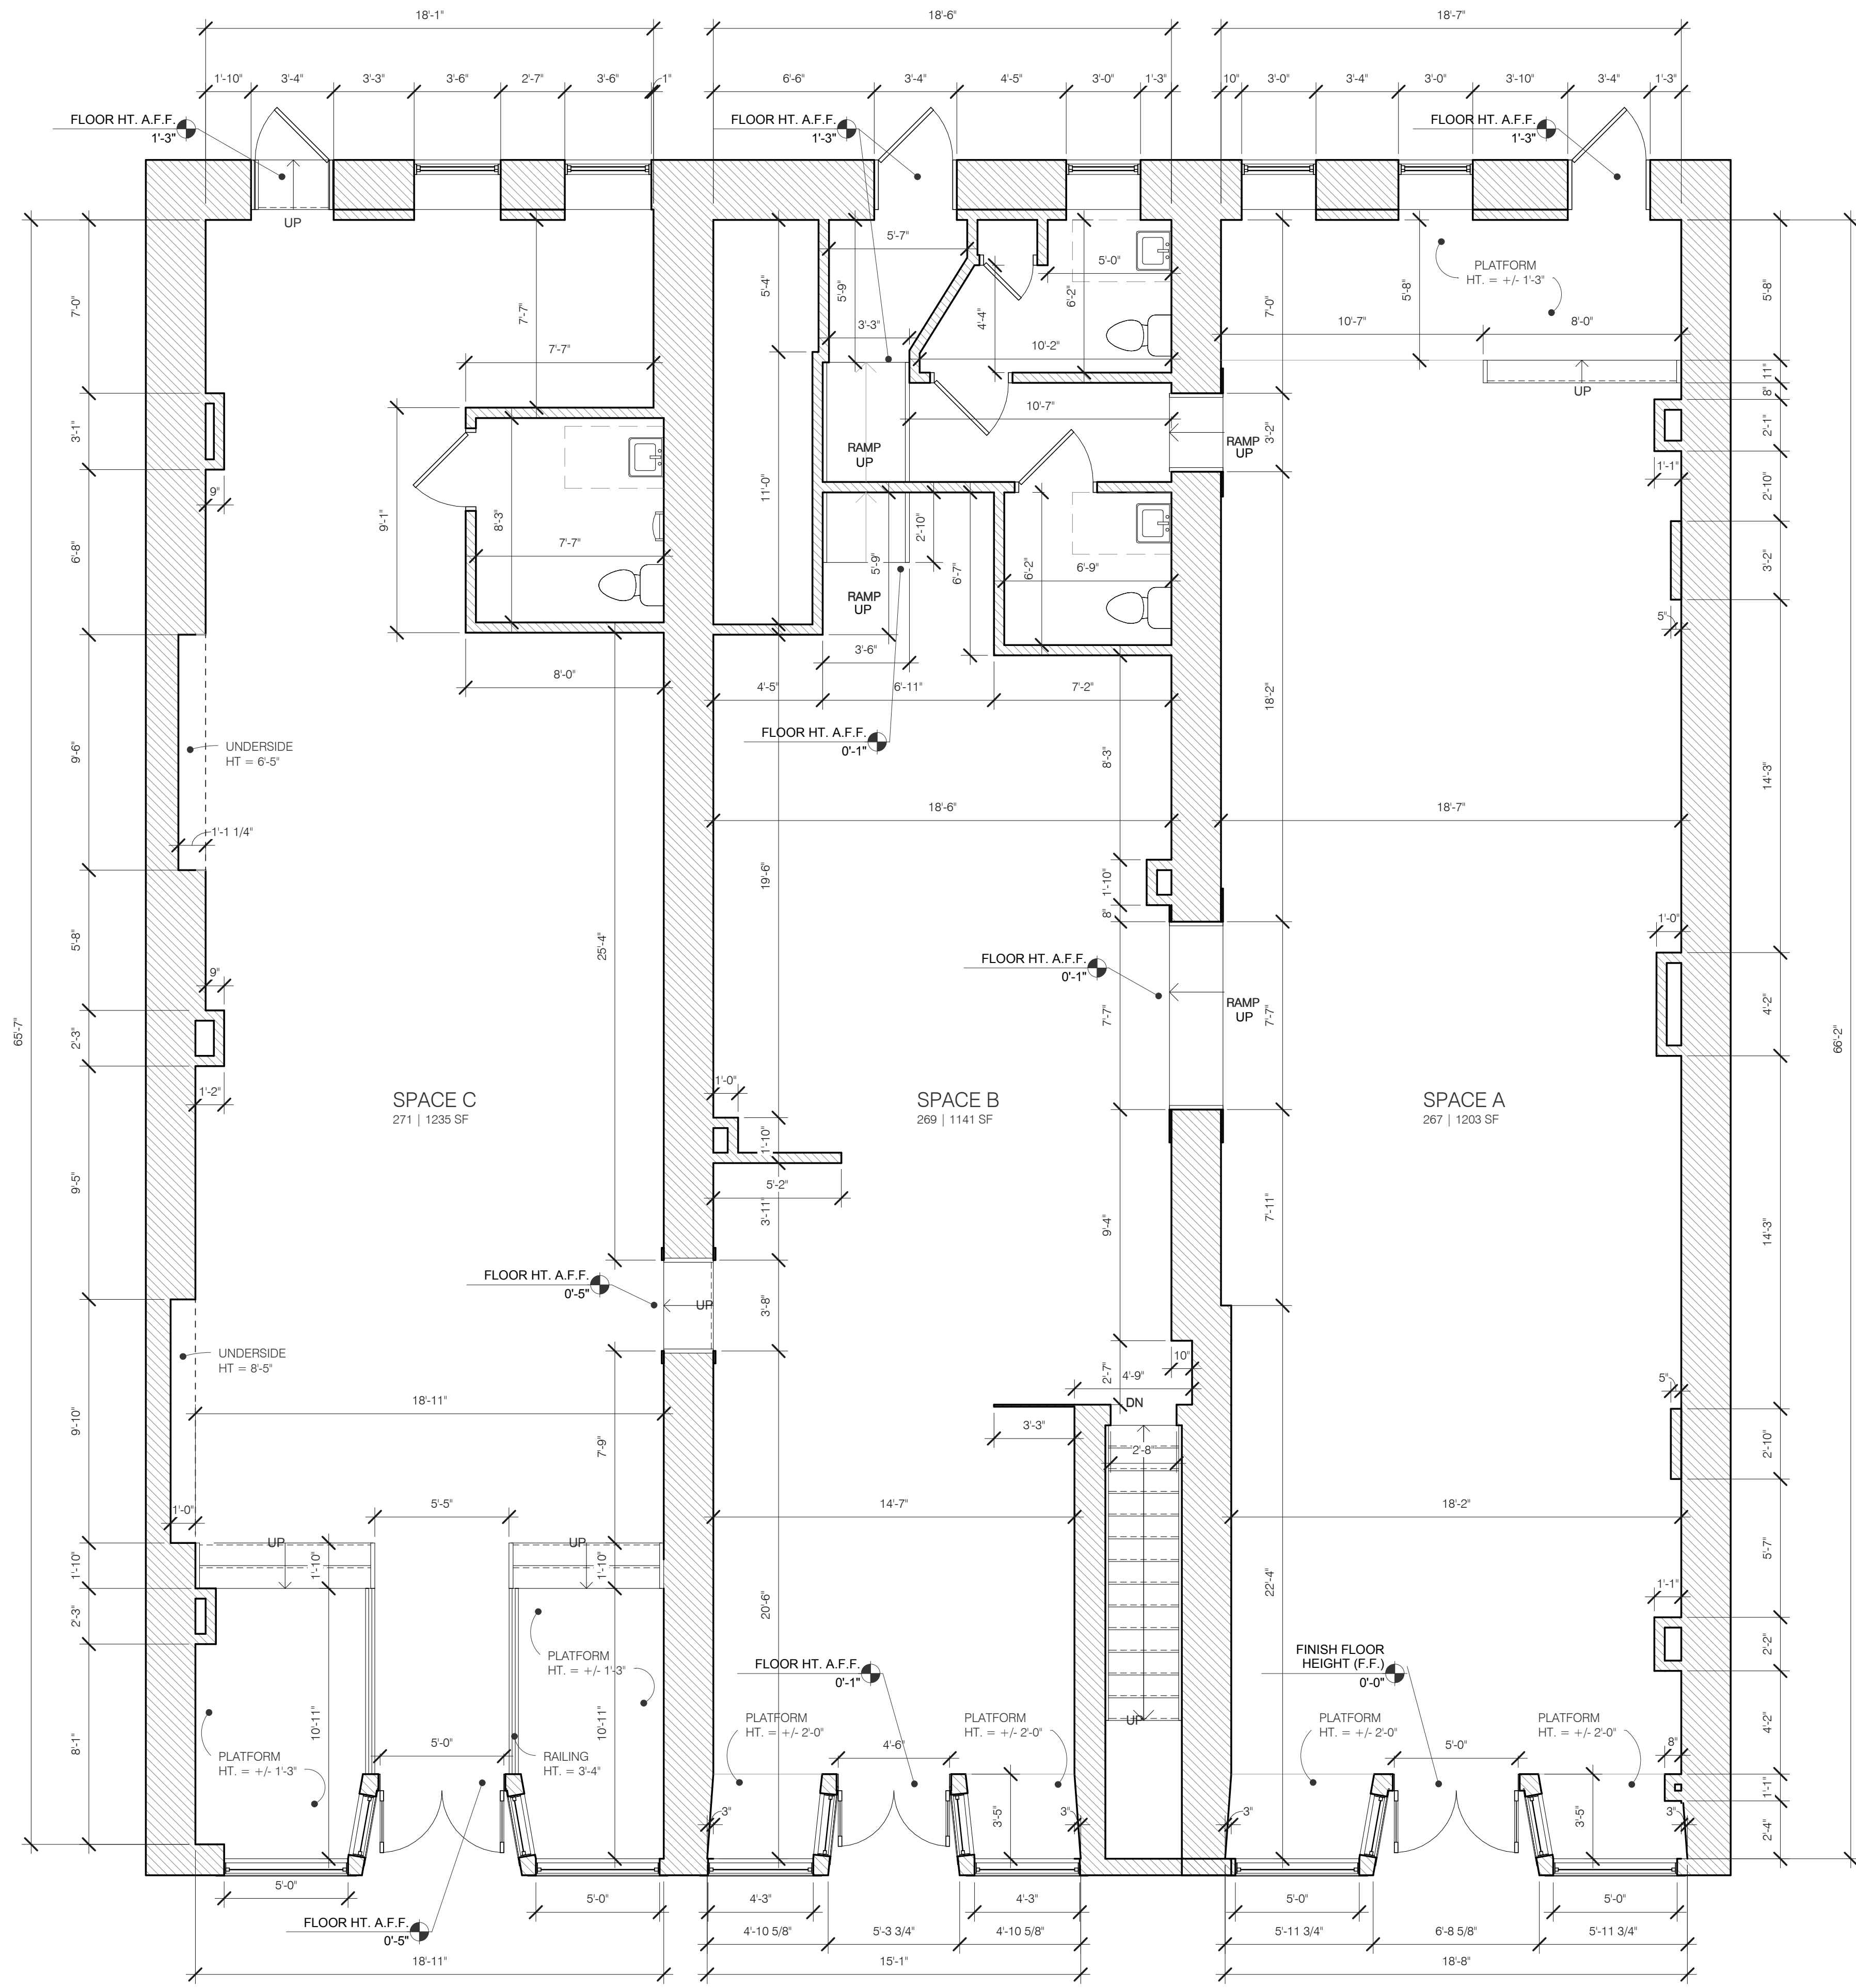

**1** LEVEL 1 - FLOOR PLAN  
EX101 1/4" = 1'-0"

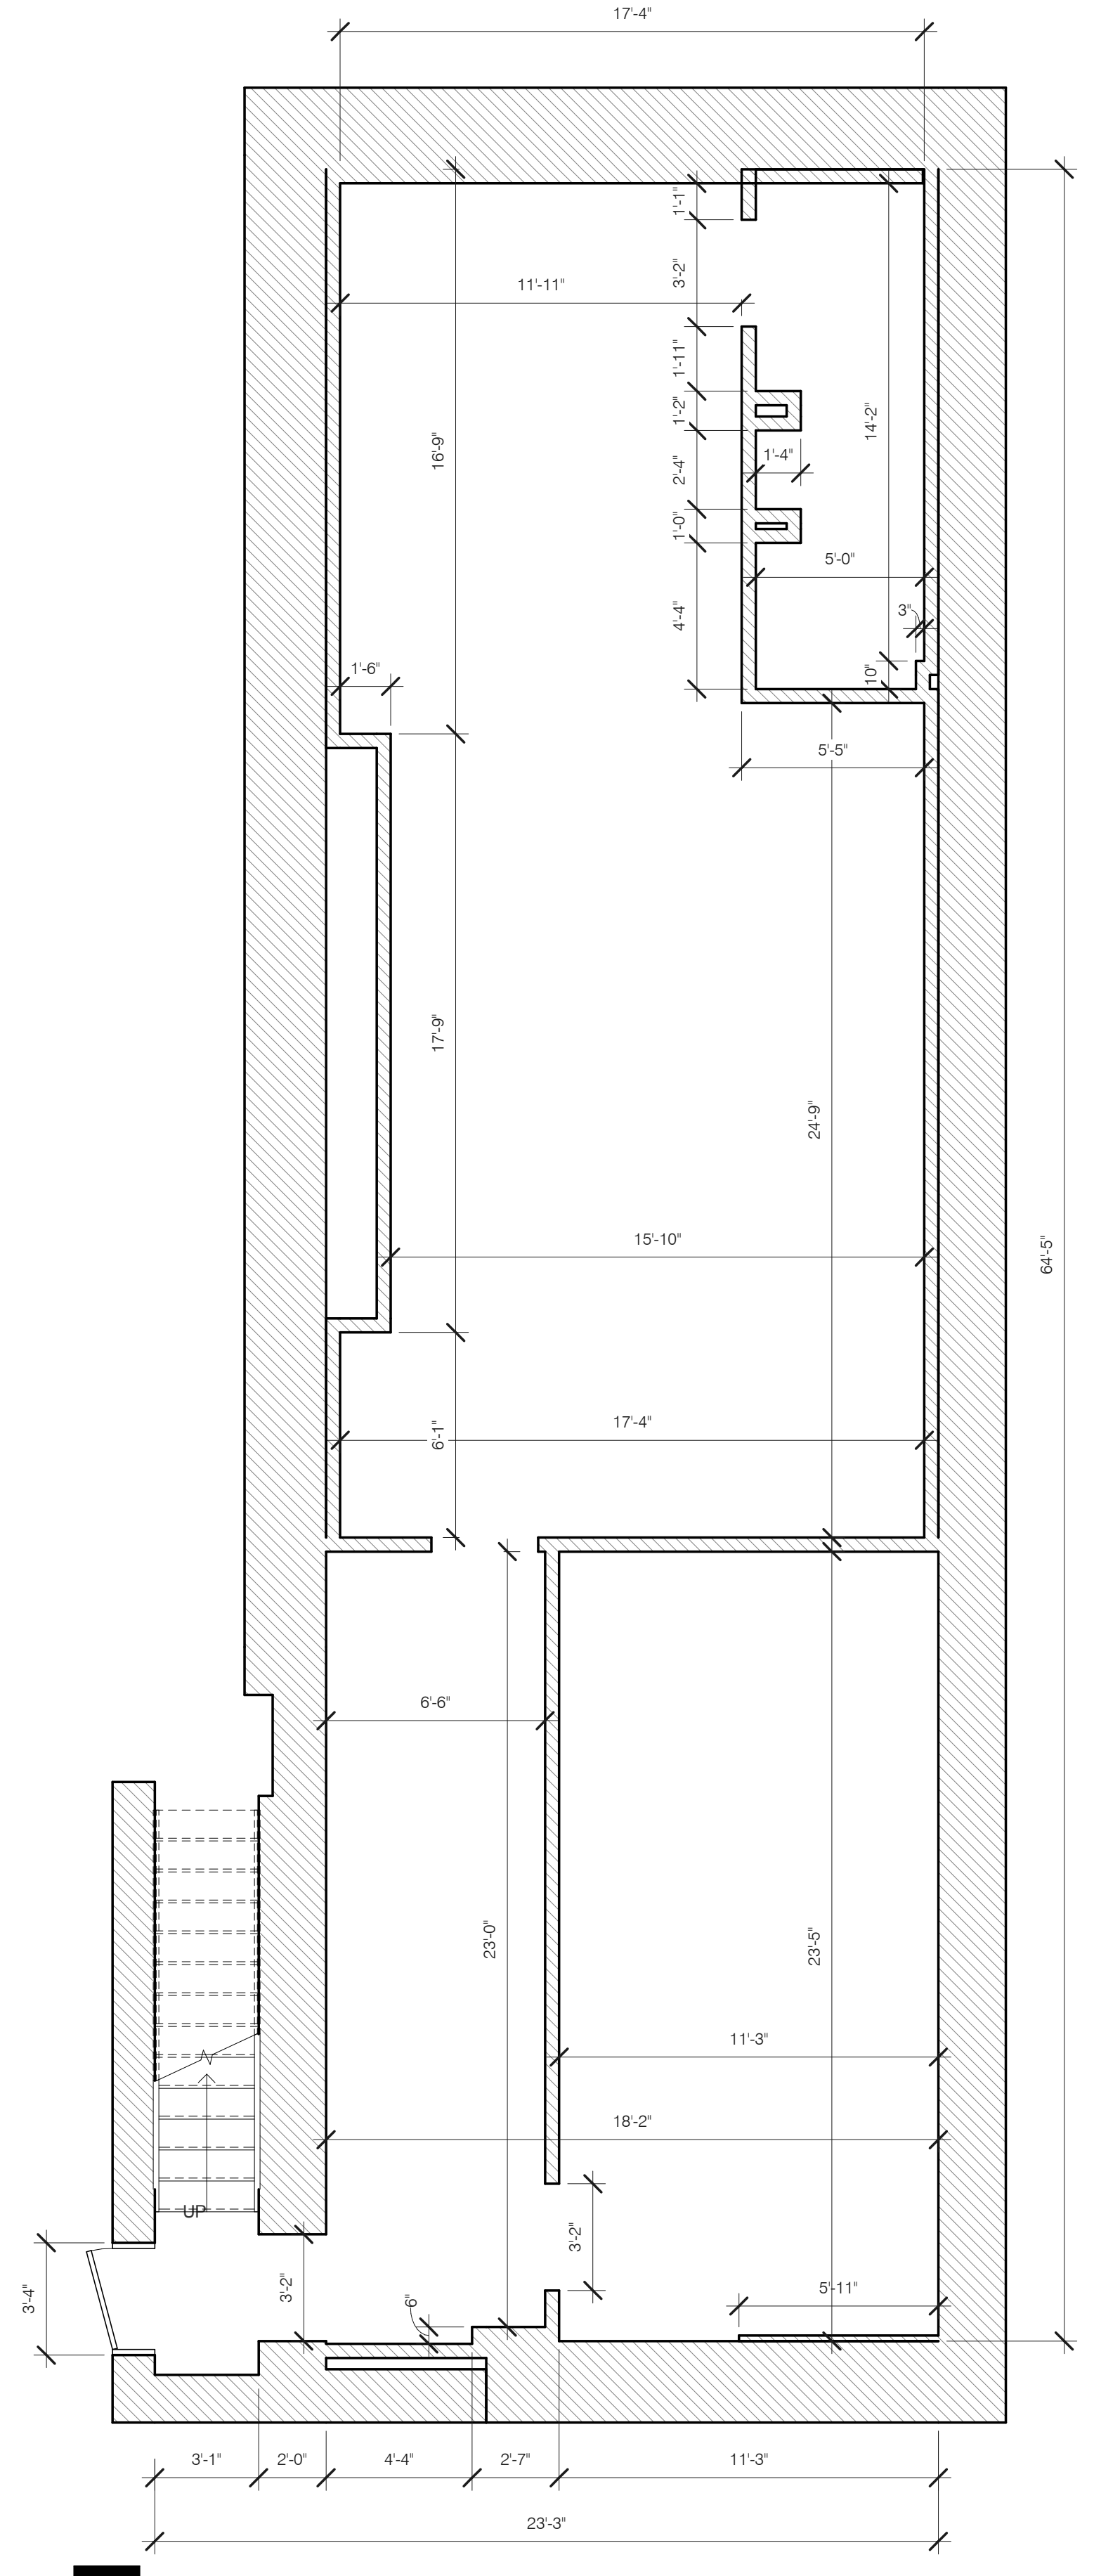

**2** SUBLEVEL - FLOOR PLAN  
EX101 1/4" = 1'-0"



901 NORTH THIRD STREET, SUITE 145  
MINNEAPOLIS, MN 55401  
612.455.3100

CONSULTANT

**PRELIMINARY**  
**NOT FOR CONSTRUCTION**

REVISIONS


#	Date	Description

DATE	3.24.14
PROJECT #	14-0017
PHASE	AS BUILTS

DRAWN BY	Author
CHECKED BY	Checker


REFLECTED  
CEILING  
PLANS

EX801

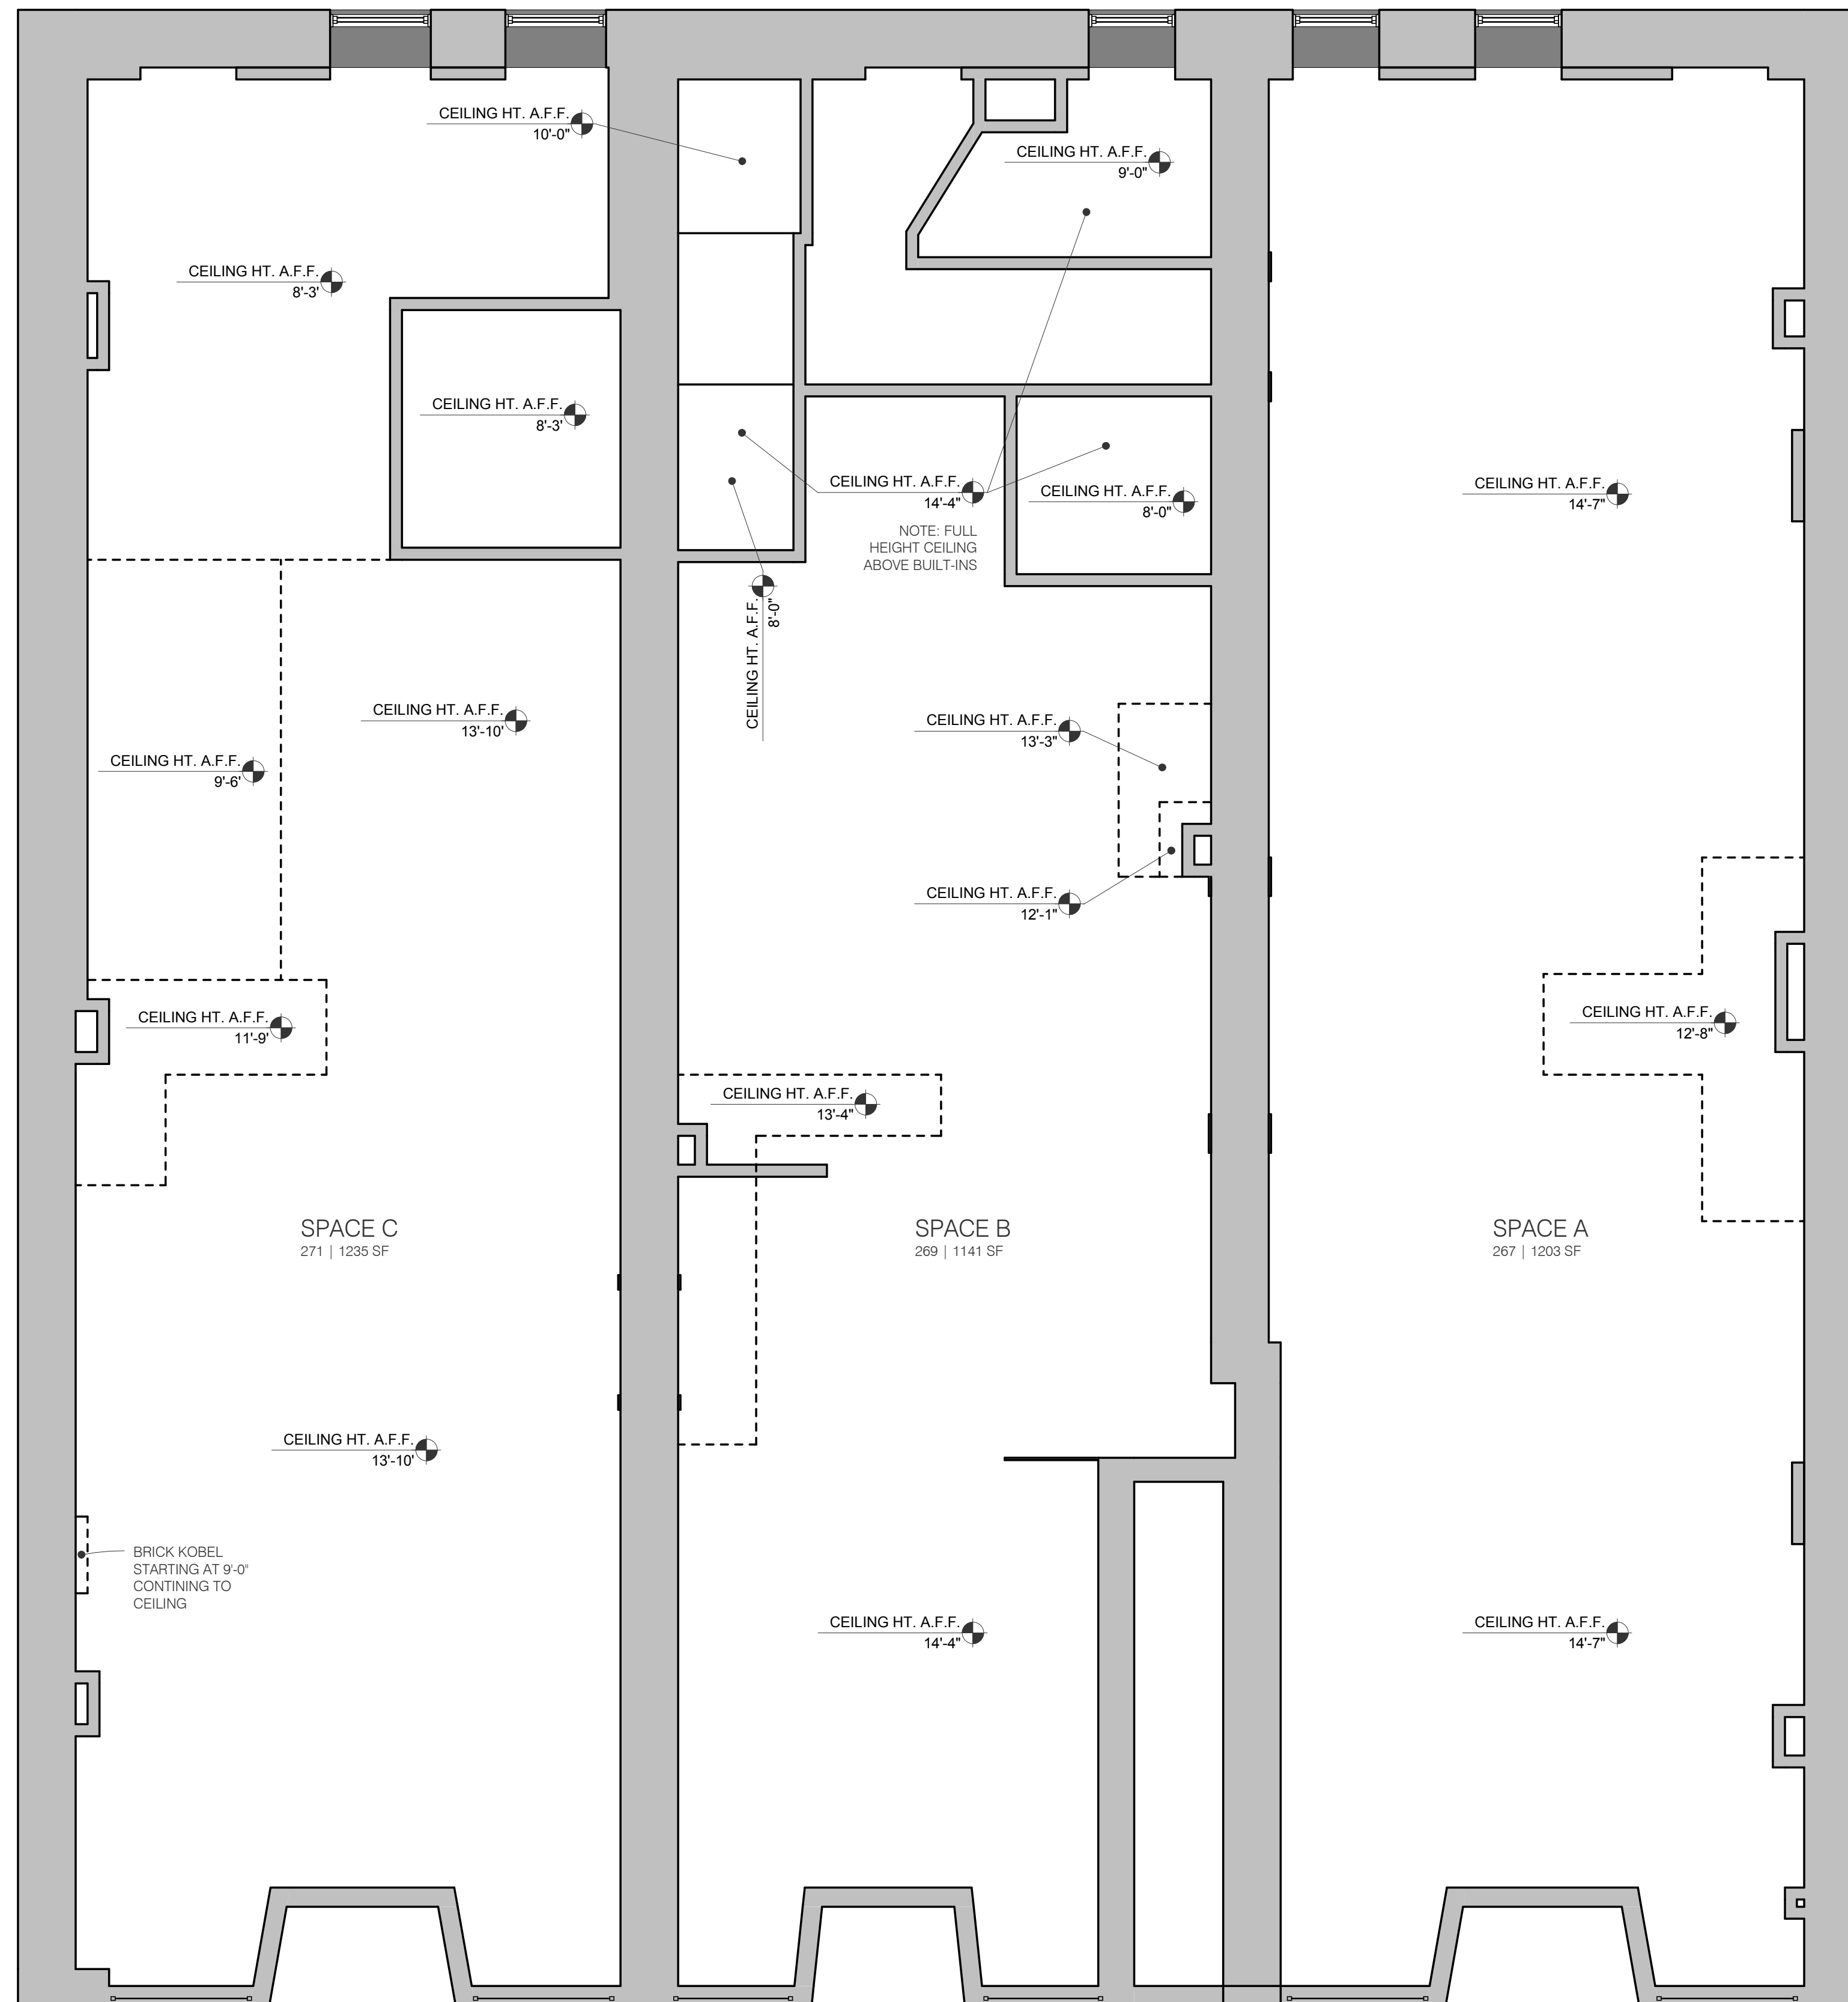

**2** LEVEL 1 - REFLECTED CEILING PLAN

EX801 1/4" = 1'-0"

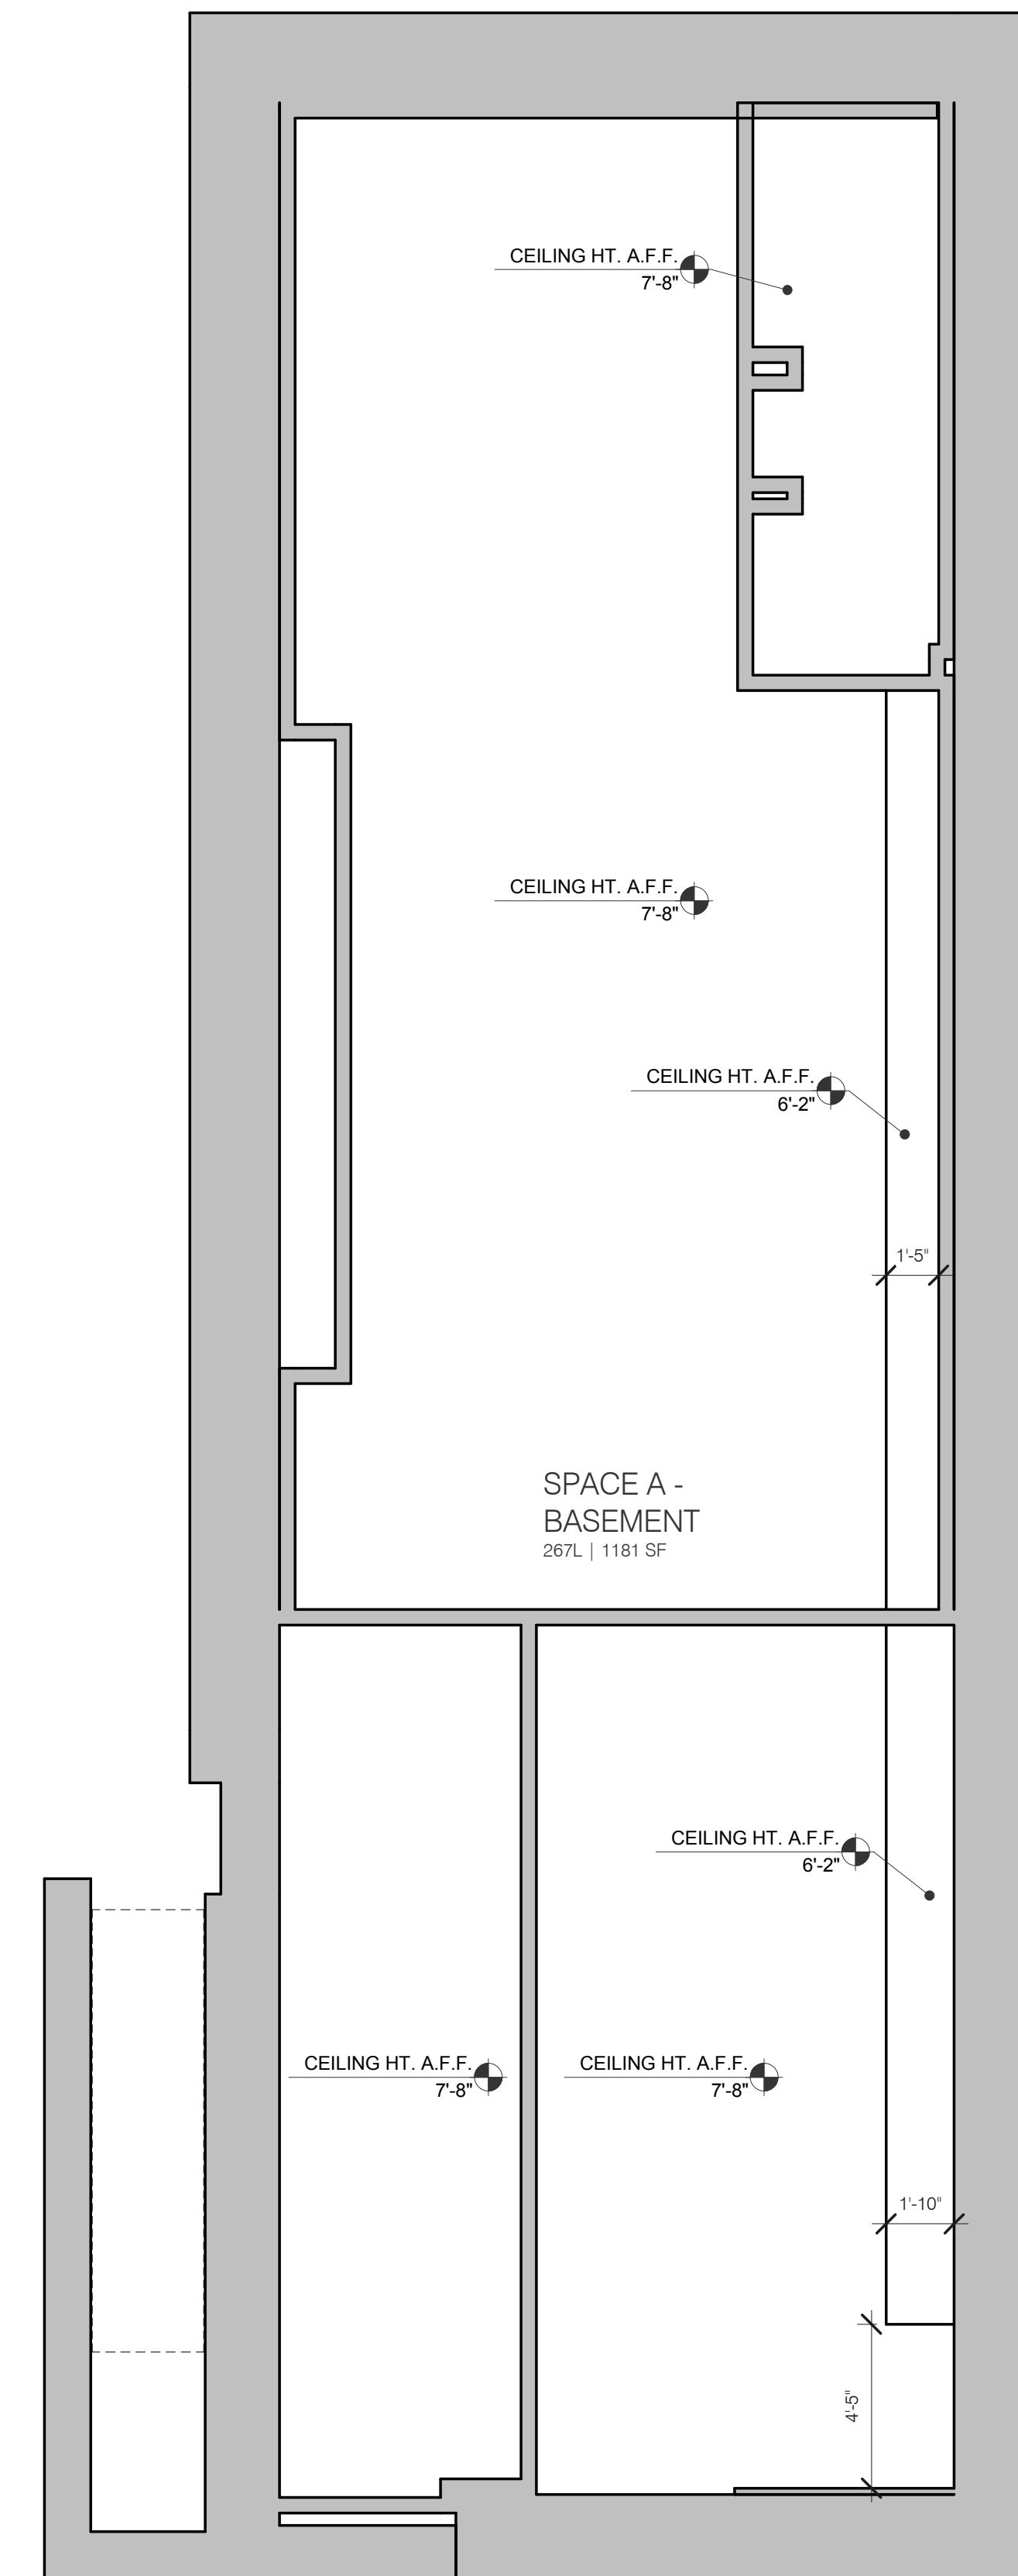

**1** SUBLEVEL - REFLECTED CEILING PLAN

EX801 1/4" = 1'-0"